


WATER VALVE BOOK BY INTERSECTION


Card Number L-425

Valve #	Size	Turns	Open or Closed	Date Installed	Old Valve #	Remarks
1	16	51	OPEN	4/30/73		MV
2	20	125	OPEN	4/30/73		MV
3	8		CLOSE	11/18/83		BO-TO SEWER
4	6		OPEN			MV
5	6		OPEN	12/19/74		HV
6	6		CLOSE		P-415	PV
7	4		OPEN		P-306	PV-SPRINKLER
8	4		OPEN		P-245	PV TO ELEVATOR
9	4		OPEN			PV
10	6		OPEN			HV
11	4		OPEN			PV TO CITY HALL
12						
13						
14						
15						
16						

Reference: D BK A-49

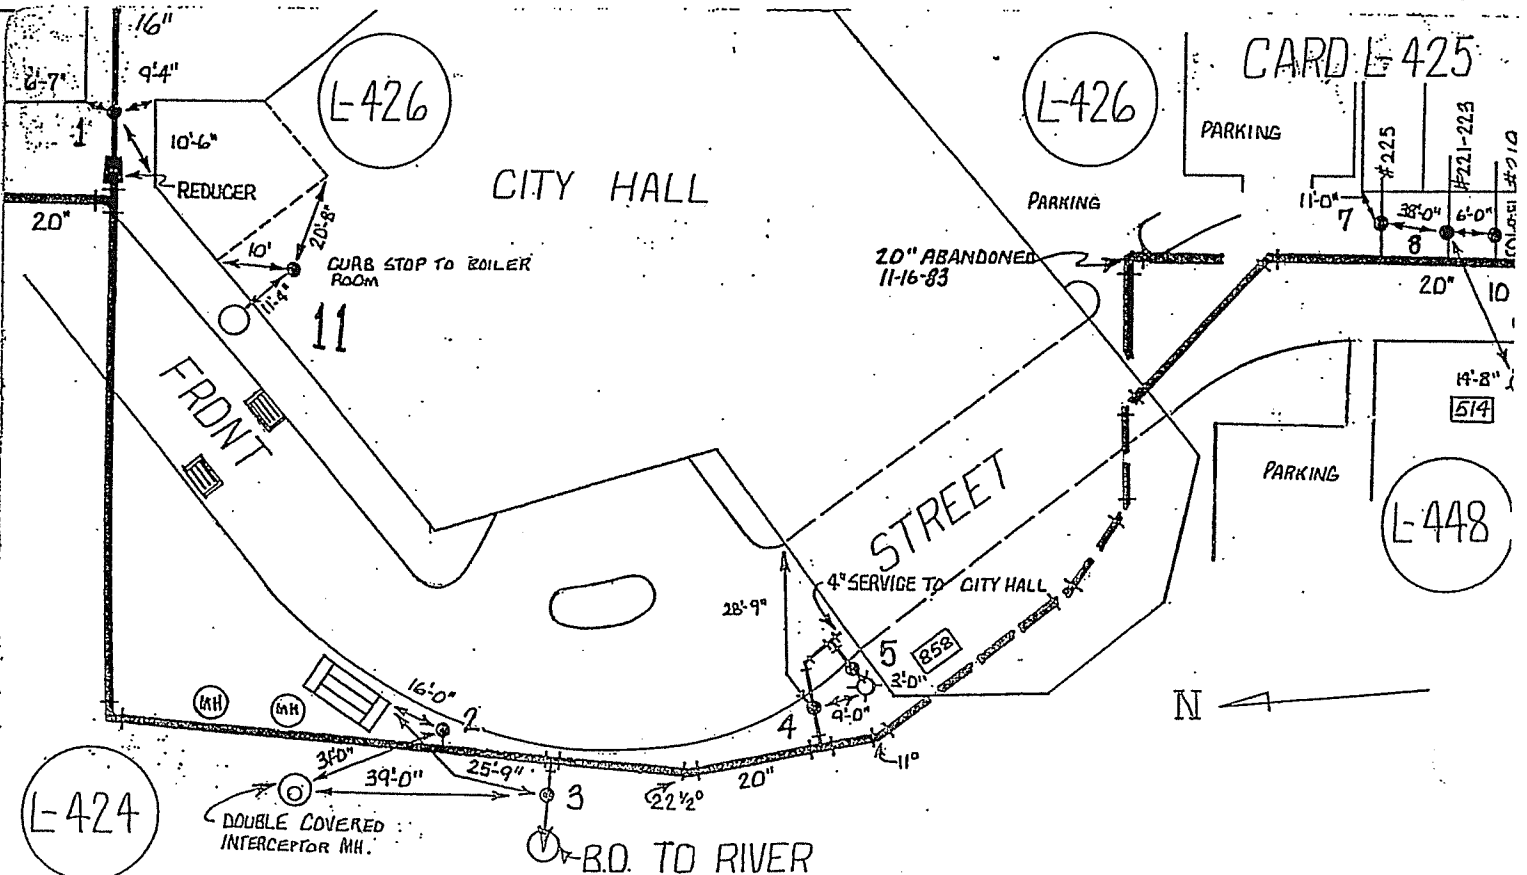

NUMBER: 425
 DATE: 5/ '32

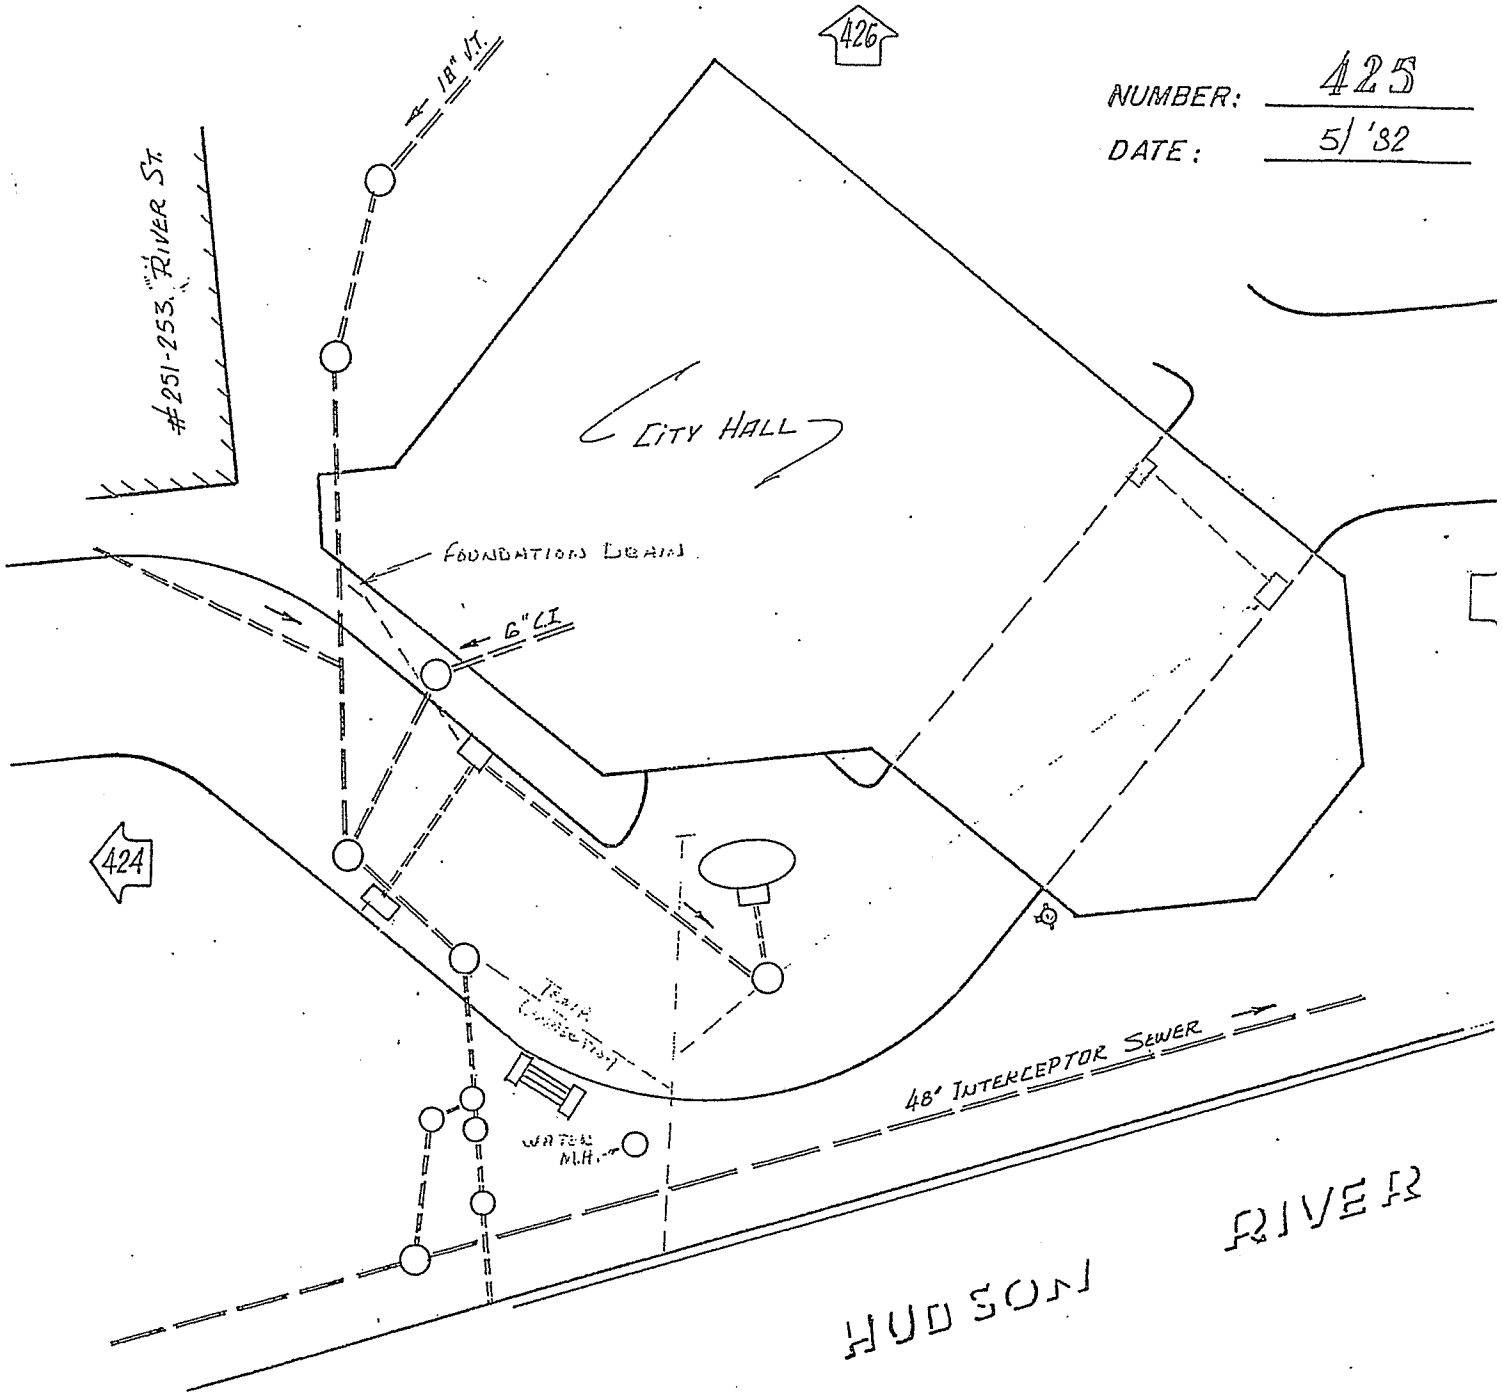

NUMBER	M.H. / C.B.	MAIN SIZE	ELEVATIONS		REMARKS
			N.S. RIM	INVERT (E.F.)	

REFERENCE.